




17425 Ballinger Way NE
 Lake Forest Park, WA 98155
 Phone: (206) 368-5440 Fax:
 (206) 364-6521

OFFICE USE ONLY	
Application Date	6-9-17
Application Number	2017-SSA-0007
Certificate Availability Fee	\$100.00
Amount Received	\$

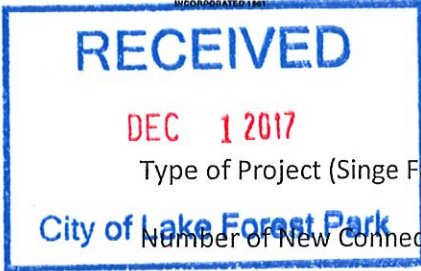

Certificate of Sewer Availability

Type of Project (Single Family Residents, Subdivision, etc.): SFA - CLUSTER HOMES

Number of New Connections: 7 Site Address: 3030 NE 200TH ST.

Parcel Number(s): 4022900741

Owner of Record: CAO JIE - PENDING SALE TO NORTH CITY HOMES LLC

Contact Name: BRIAN HILBERGER Contact Phone: (206) 920 2830

OFFICE USE ONLY	
Sewer Information (To Be Completed By Sewer District)	
<input checked="" type="checkbox"/> Sewer service will be provided by connection to an existing <u>8" (verification req'd)</u> size sewer <u>30±</u> feet from the property line and the sewer system has the capacity to serve the propose use.	
Or sewer service will require an improvement of:	
<input type="checkbox"/> _____ feet or sewer trunk or lateral to reach the property line.	
<input type="checkbox"/> Pressure System:	
<input type="checkbox"/> Other: _____	
Sewer service is subject to the following:	
<input checked="" type="checkbox"/> Connection Charge	
<input type="checkbox"/> Easement(s) <input type="checkbox"/> As-builts:	
<input type="checkbox"/> Other	
<i>I, representative of the Lake Forest Park Sewer District, hereby certify that the above information is true. This certification is valid for one year from date of signature.</i>	
<u>Mai Jim</u> Name	<u>City Engineer</u> Title
	<u>6/15/17</u> Date

RONALD SEWER DISTRICT

MAINTENANCE DIVISION

SEWER PLAT

CARD NUMBER

10827-20000

7294

3159 NE

OWNER

LESFAN

CONTRACTOR

HERROLD


PLAT AND PERMIT No.

4984

EASEMENT No.



1" = 50'

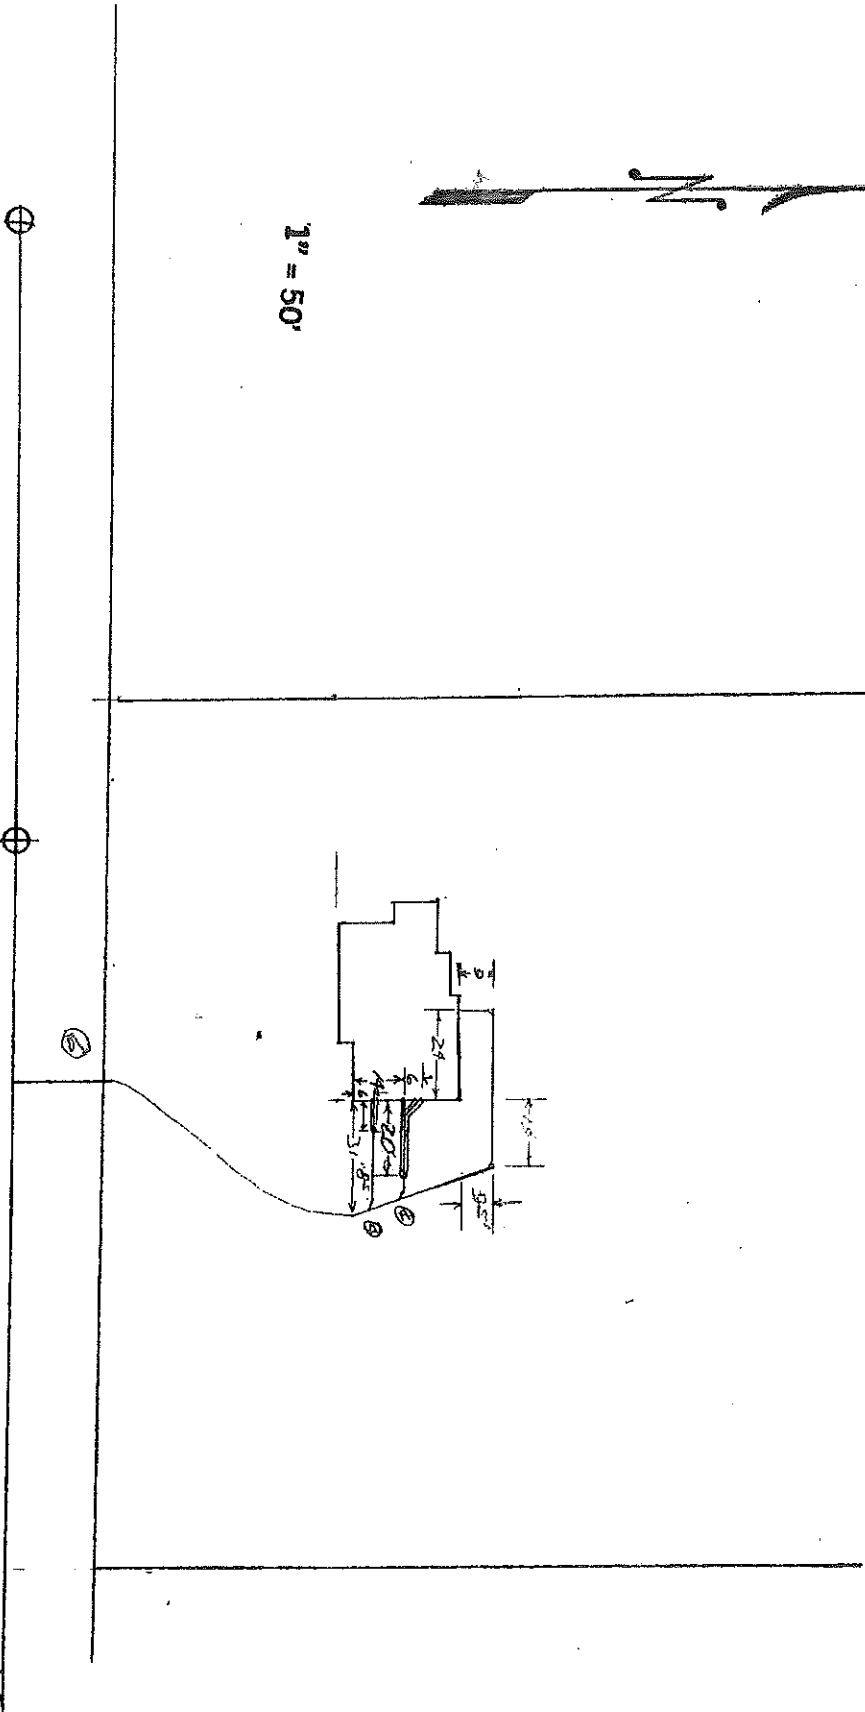

- 1. Depth at Property Line..... or Concrete Walk (reference to Curb)
- 2. Depth of Building..... (reference to First Floor)
- 3. Minimum Grade from Main to Property Line..... from Property Line to Building
- 4. Number of Wyes..... Distance M. H. to Pr. Line..... Distance, Man Hole to Bldg. Line..... Building Located.....

Kind of Pipe

CBV AC CI

NE 200 TH

3030-NE-200

Approved: DISTRICT ENGINEER

Entered on Card Date

9-21-70

I HEREBY CERTIFY THAT THE ABOVE CONNECTION HAS BEEN MADE AS SHOWN:

By

HR

Inspector:

RVDV

DATE

6-13-69

